REV	DESCRIPTION	DRAWN	DATE
		APPROVED	DATE
A	ITEMS UPDATED TO AS BUILT	R.STEWART	04-APR-2005
		R.STEWART	11-APR-2005

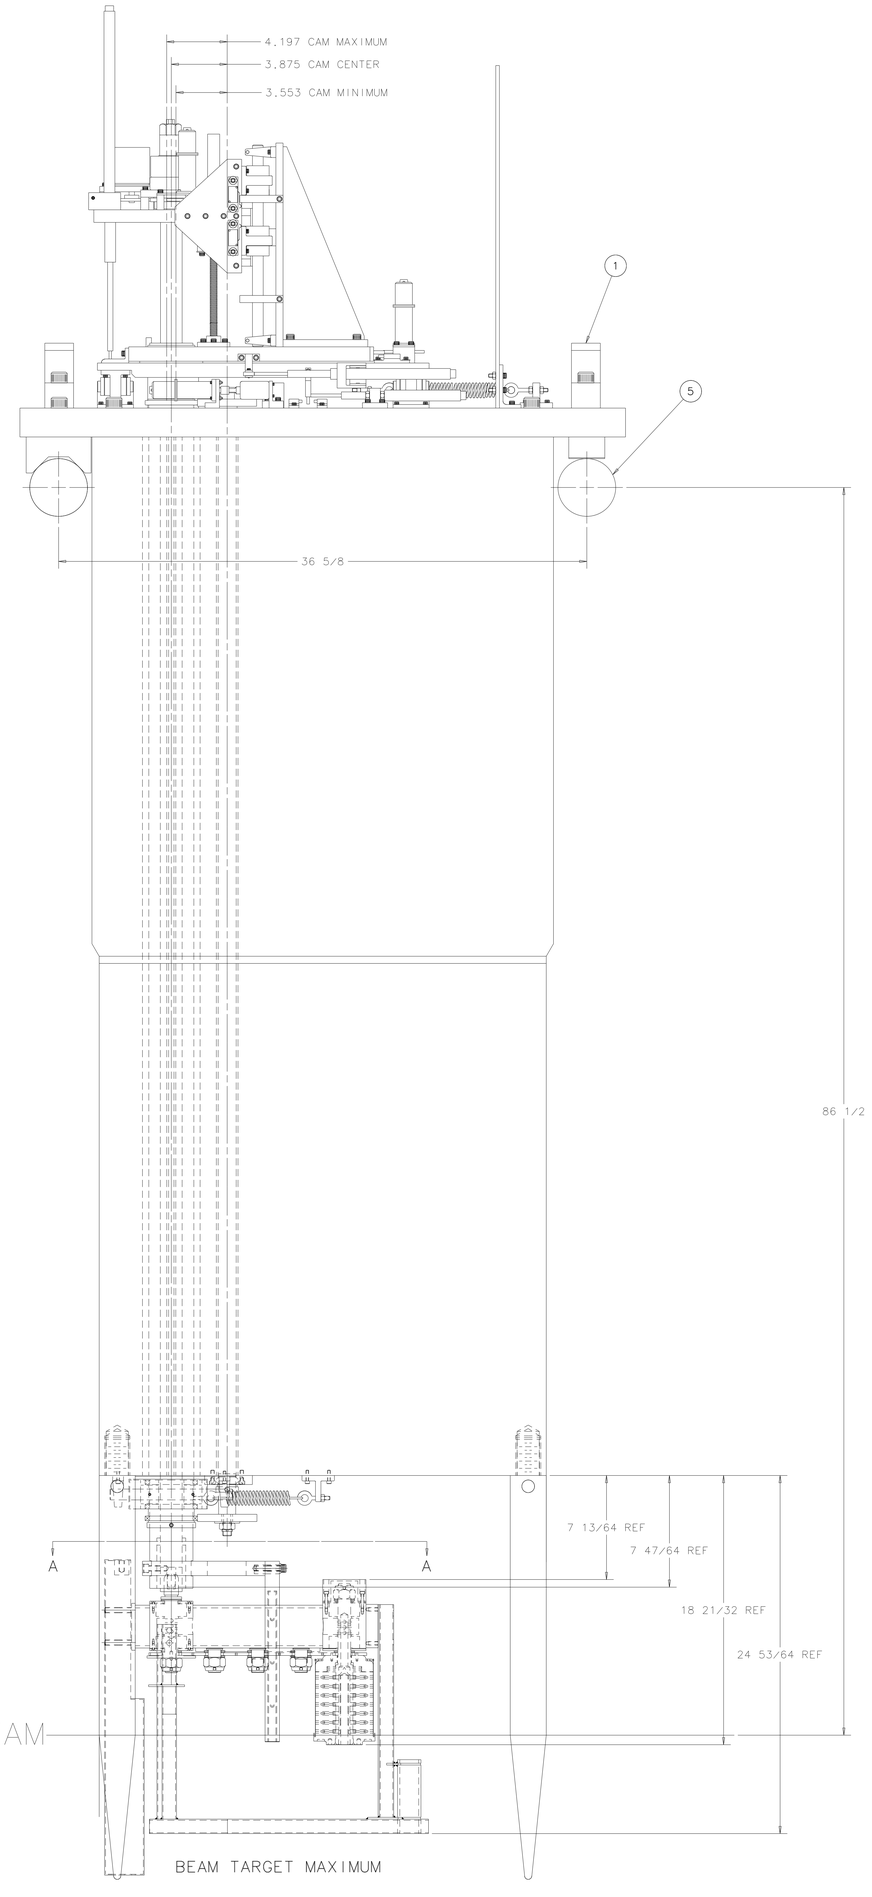

BEAM TARGET MAXIMUM

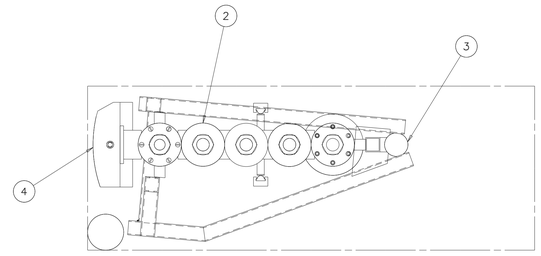

VIEW A-A

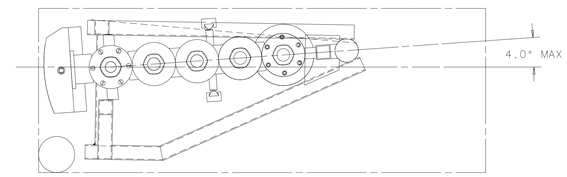

COUNTER CLOCKWISE ROTATION

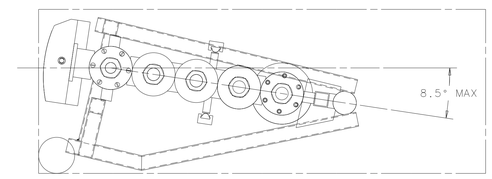

CLOCKWISE ROTATION

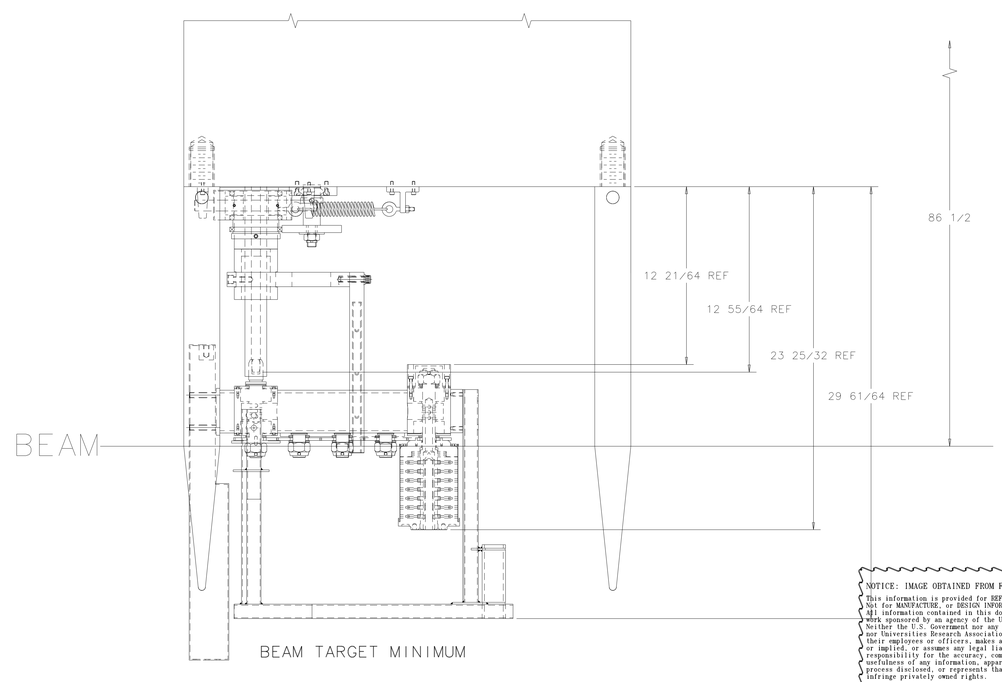

BEAM TARGET MINIMUM

ITEM	PART NO.	DESCRIPTION OR SIZE	QTY.
5	MB-322214	RAIL	2
4	MD-413290	SHELL FOR LEAD FILL	1
3	ME-254191	TARGET STAND	1
2	ME-375342	TARGET ASSEMBLY MARK 3	1
1	ME-413291	MODULE ASSEMBLY	1

PARTS LIST

UNLESS OTHERWISE SPECIFIED			ORIGINATOR	R.SCHULTZ	08-JAN-2004
FRACTIONS	DECIMALS	ANGLES	DRAWN	R.STEWART	08-JAN-2004
± 1/16	± .015	± 1°	CHECKED	R.SCHULTZ	31-AUG-2004
			APPROVED	R.SCHULTZ	31-AUG-2004
			USED ON		
			MATERIAL	SEE PARTS LIST	

1. BREAK ALL SHARP EDGES .015 MAX.
2. DO NOT SCALE DRAWING.
3. DIMENSIONS BASED UPON ANSI Y14.5M-1982
4. MAX. ALL MACH. SURFACES 125

FERMI NATIONAL ACCELERATOR LABORATORY
UNITED STATES DEPARTMENT OF ENERGY

PBAR SOURCE
TARGET MODULE MARK 2
MODULE TARGET ASSEMBLY

SCALE	DRAWING NUMBER	SHEET	REV
1:4	8055.110-ME-413340	1 OF 1	A

CREATED WITH : Ideas11NXSeries | GROUP: ACCELERATOR MECH. SUPPT.

NOTICE: IMAGE OBTAINED FROM FERMILAB WEB SITE

This information is provided for REFERENCE use only. Not for MANUFACTURE, or DESIGN INFORMATION. All information contained in this document represents work sponsored by an agency of the U.S. Government. Neither the U.S. Government nor any agency thereof, nor Universities Research Association, Inc., nor any of their employees or officers, makes any warranty, express or implied, or assumes any legal liability or responsibility for the accuracy, completeness, or usefulness of any information, apparatus, product or process disclosed, or represents that its use would not infringe privately owned rights.