REV	DESCRIPTION	DRAWN / APPROVED	DATE
A	REPLACE BEAMS DIVISION DWG. #8875.117-ME-363720	D.FRIEND	6/20/01
		DAVE PUSHKA	
B	UPDATE WITH ACTUAL EQUIPMENT SPECIFICATIONS	F.YOFFE	23-JUN-2003
		DAVE PUSHKA	24-JUN-2003
C	UPDATE EQUIPMENT INFO	R.L.SMITH	07-APR-2004
		R.SILVA	14-APR-2004
D	UPDATED P&ID INFO LOCATED ON TARGET SKIDS IN MECHANICAL ROOM TO AS FOUND 10-MAR-2011. PERFORMANCE VALUES CALCULATED FOR ORIGINAL DESIGN AND HAVE NOT BEEN UPDATED.	DGH	14-MAR-2011
		S.REEVES	21-SEP-2011
E	UPDATED TO AS BUILT FOR 2012 NOVA UPGRADE SHUTDOWN	D.HURD	11-JAN-2013
		K.WILLIAMS	01-AUG-2013

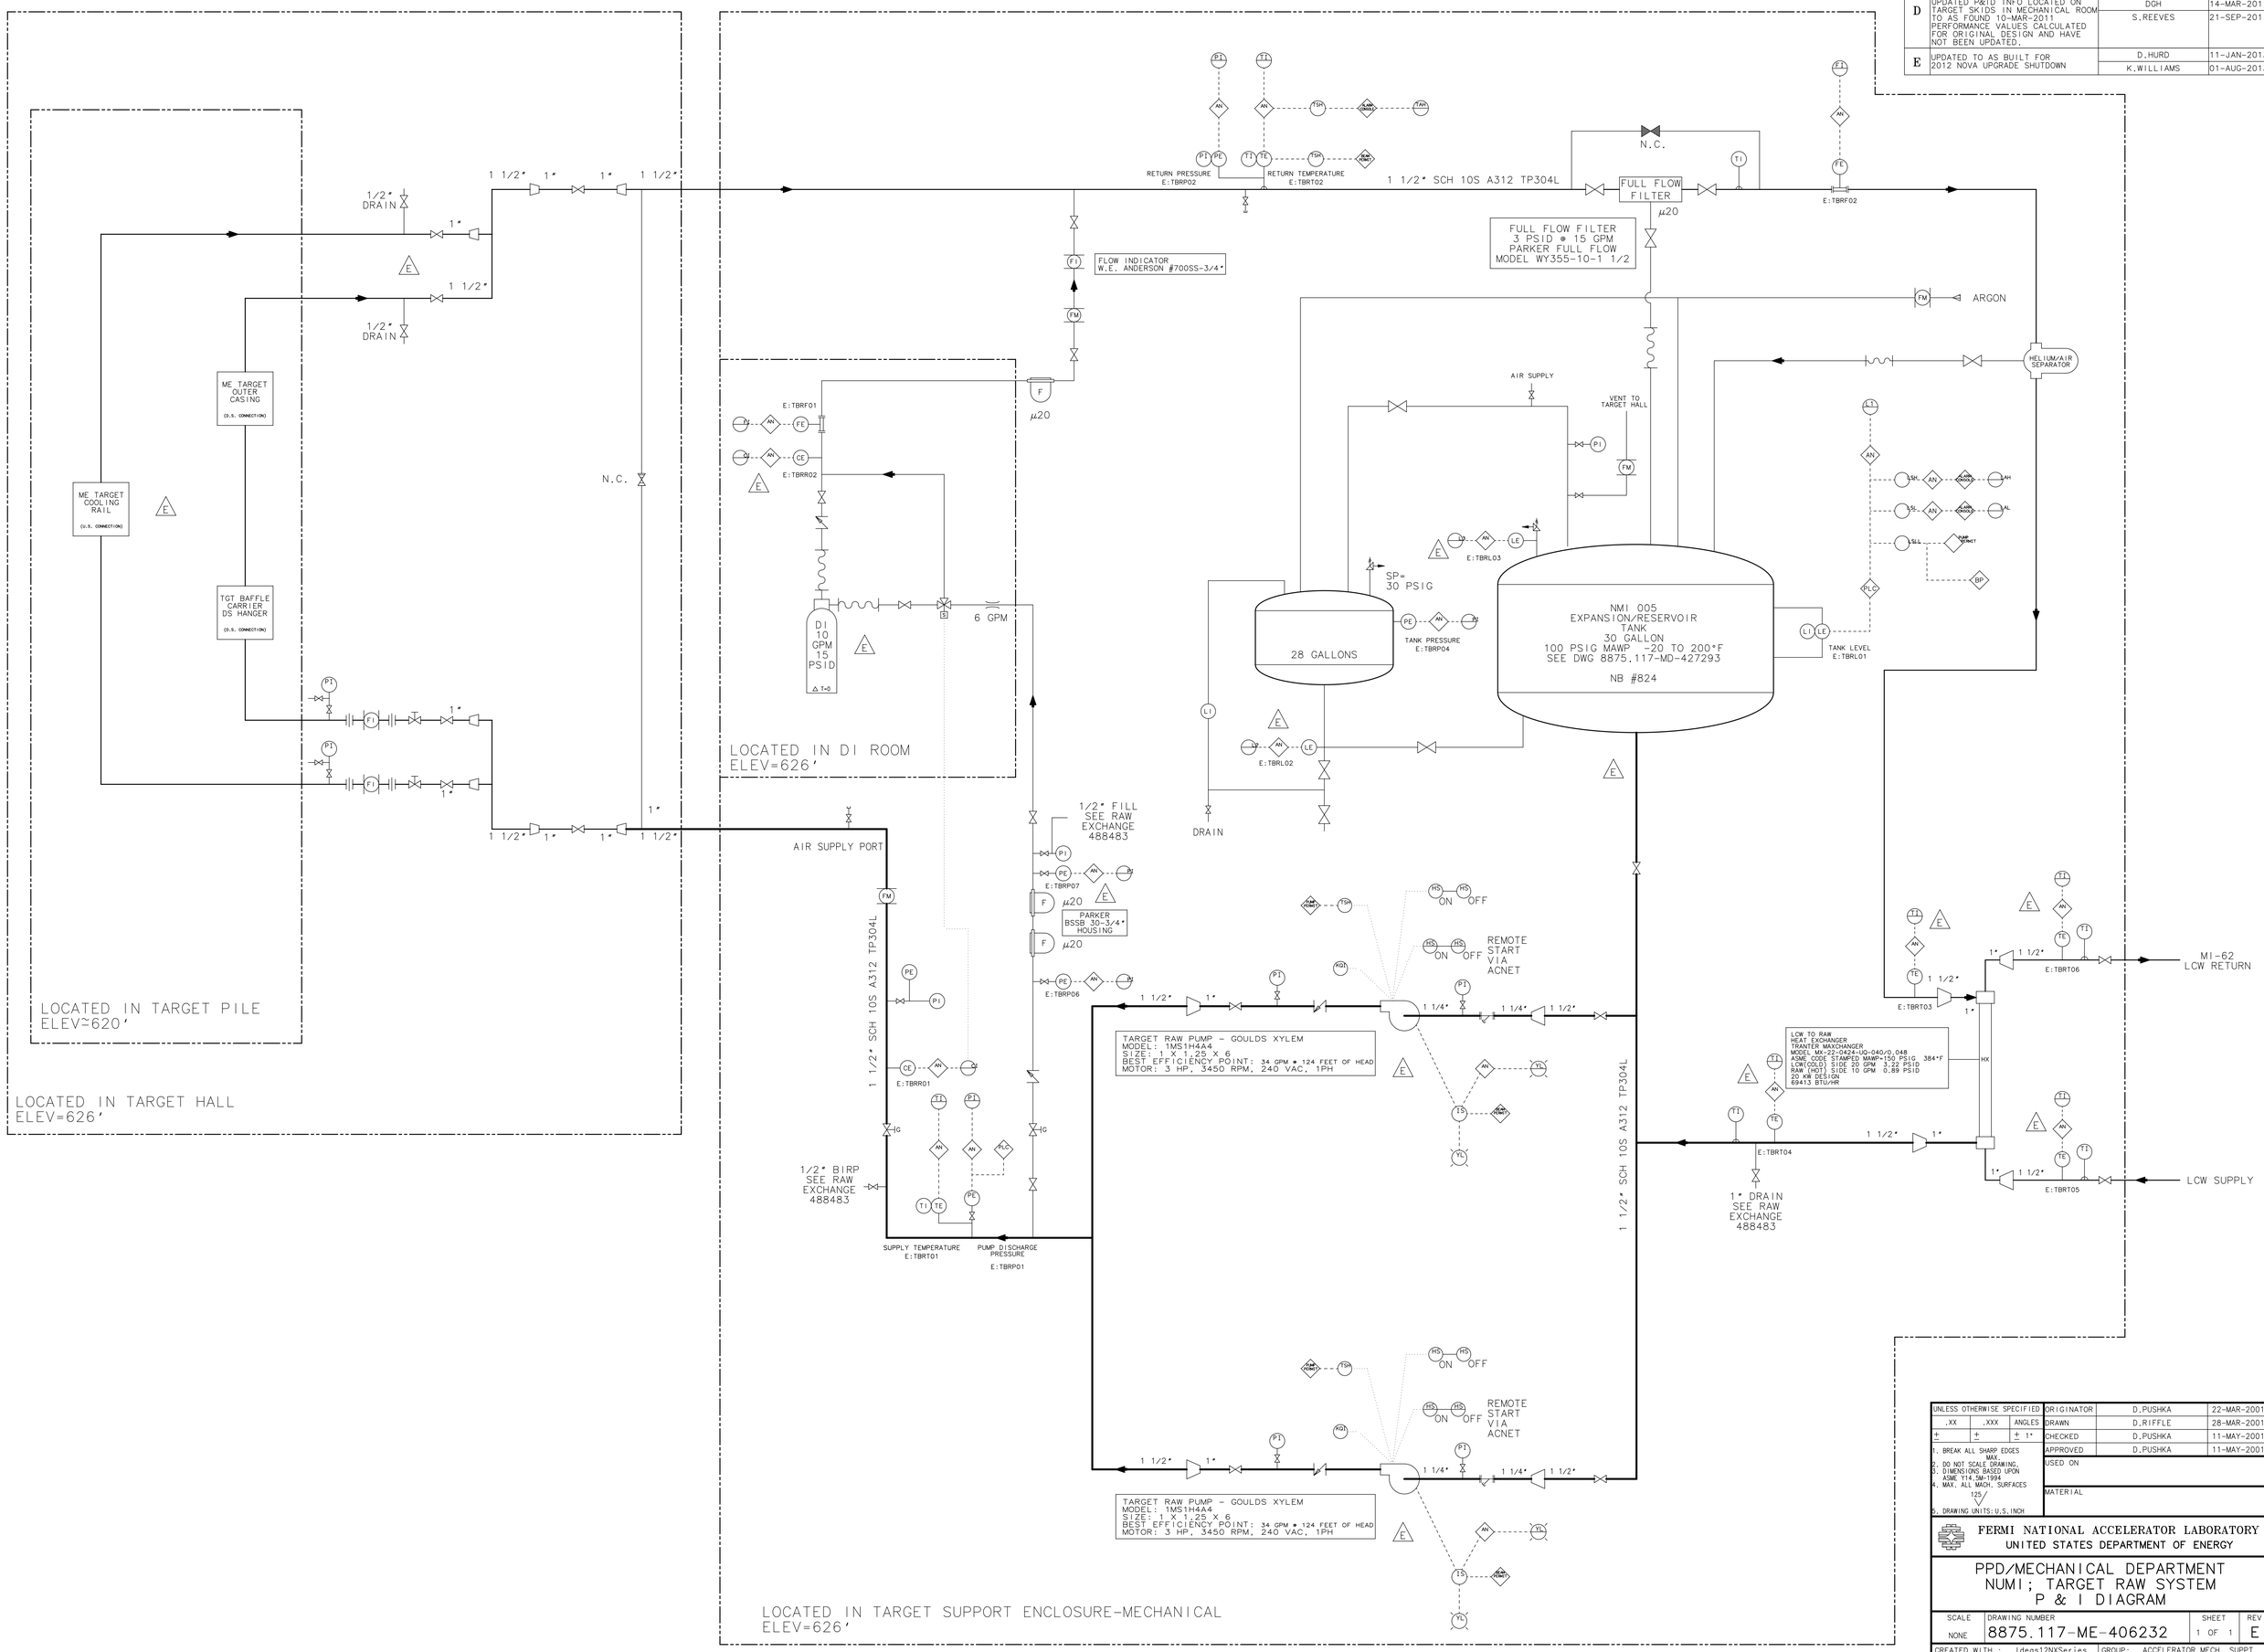

UNLESS OTHERWISE SPECIFIED			ORIGINATOR	D.PUSHKA	22-MAR-2001
.XX	.XXX	ANGLES	DRAWN	D.RIFFLE	28-MAR-2001
±	±	± 1°	CHECKED	D.PUSHKA	11-MAY-2001
1. BREAK ALL SHARP EDGES MAX.			APPROVED	D.PUSHKA	11-MAY-2001
2. DO NOT SCALE DRAWING.			USED ON		
3. DIMENSIONS BASED UPON ASME Y14.5M-1994					
4. MAX. ALL MACH. SURFACES 125			MATERIAL		
5. DRAWING UNITS:U.S.INCH					

FERMI NATIONAL ACCELERATOR LABORATORY
UNITED STATES DEPARTMENT OF ENERGY

PPD/MECHANICAL DEPARTMENT
NUMI; TARGET RAW SYSTEM
P & I DIAGRAM

SCALE	DRAWING NUMBER	SHEET	REV
NONE	8875.117-ME-406232	1 OF 1	E

CREATED WITH : Ideas12NXSeries | GROUP: ACCELERATOR MECH. SUPPT.